



14) ADD glazed wall

201115_fm LY

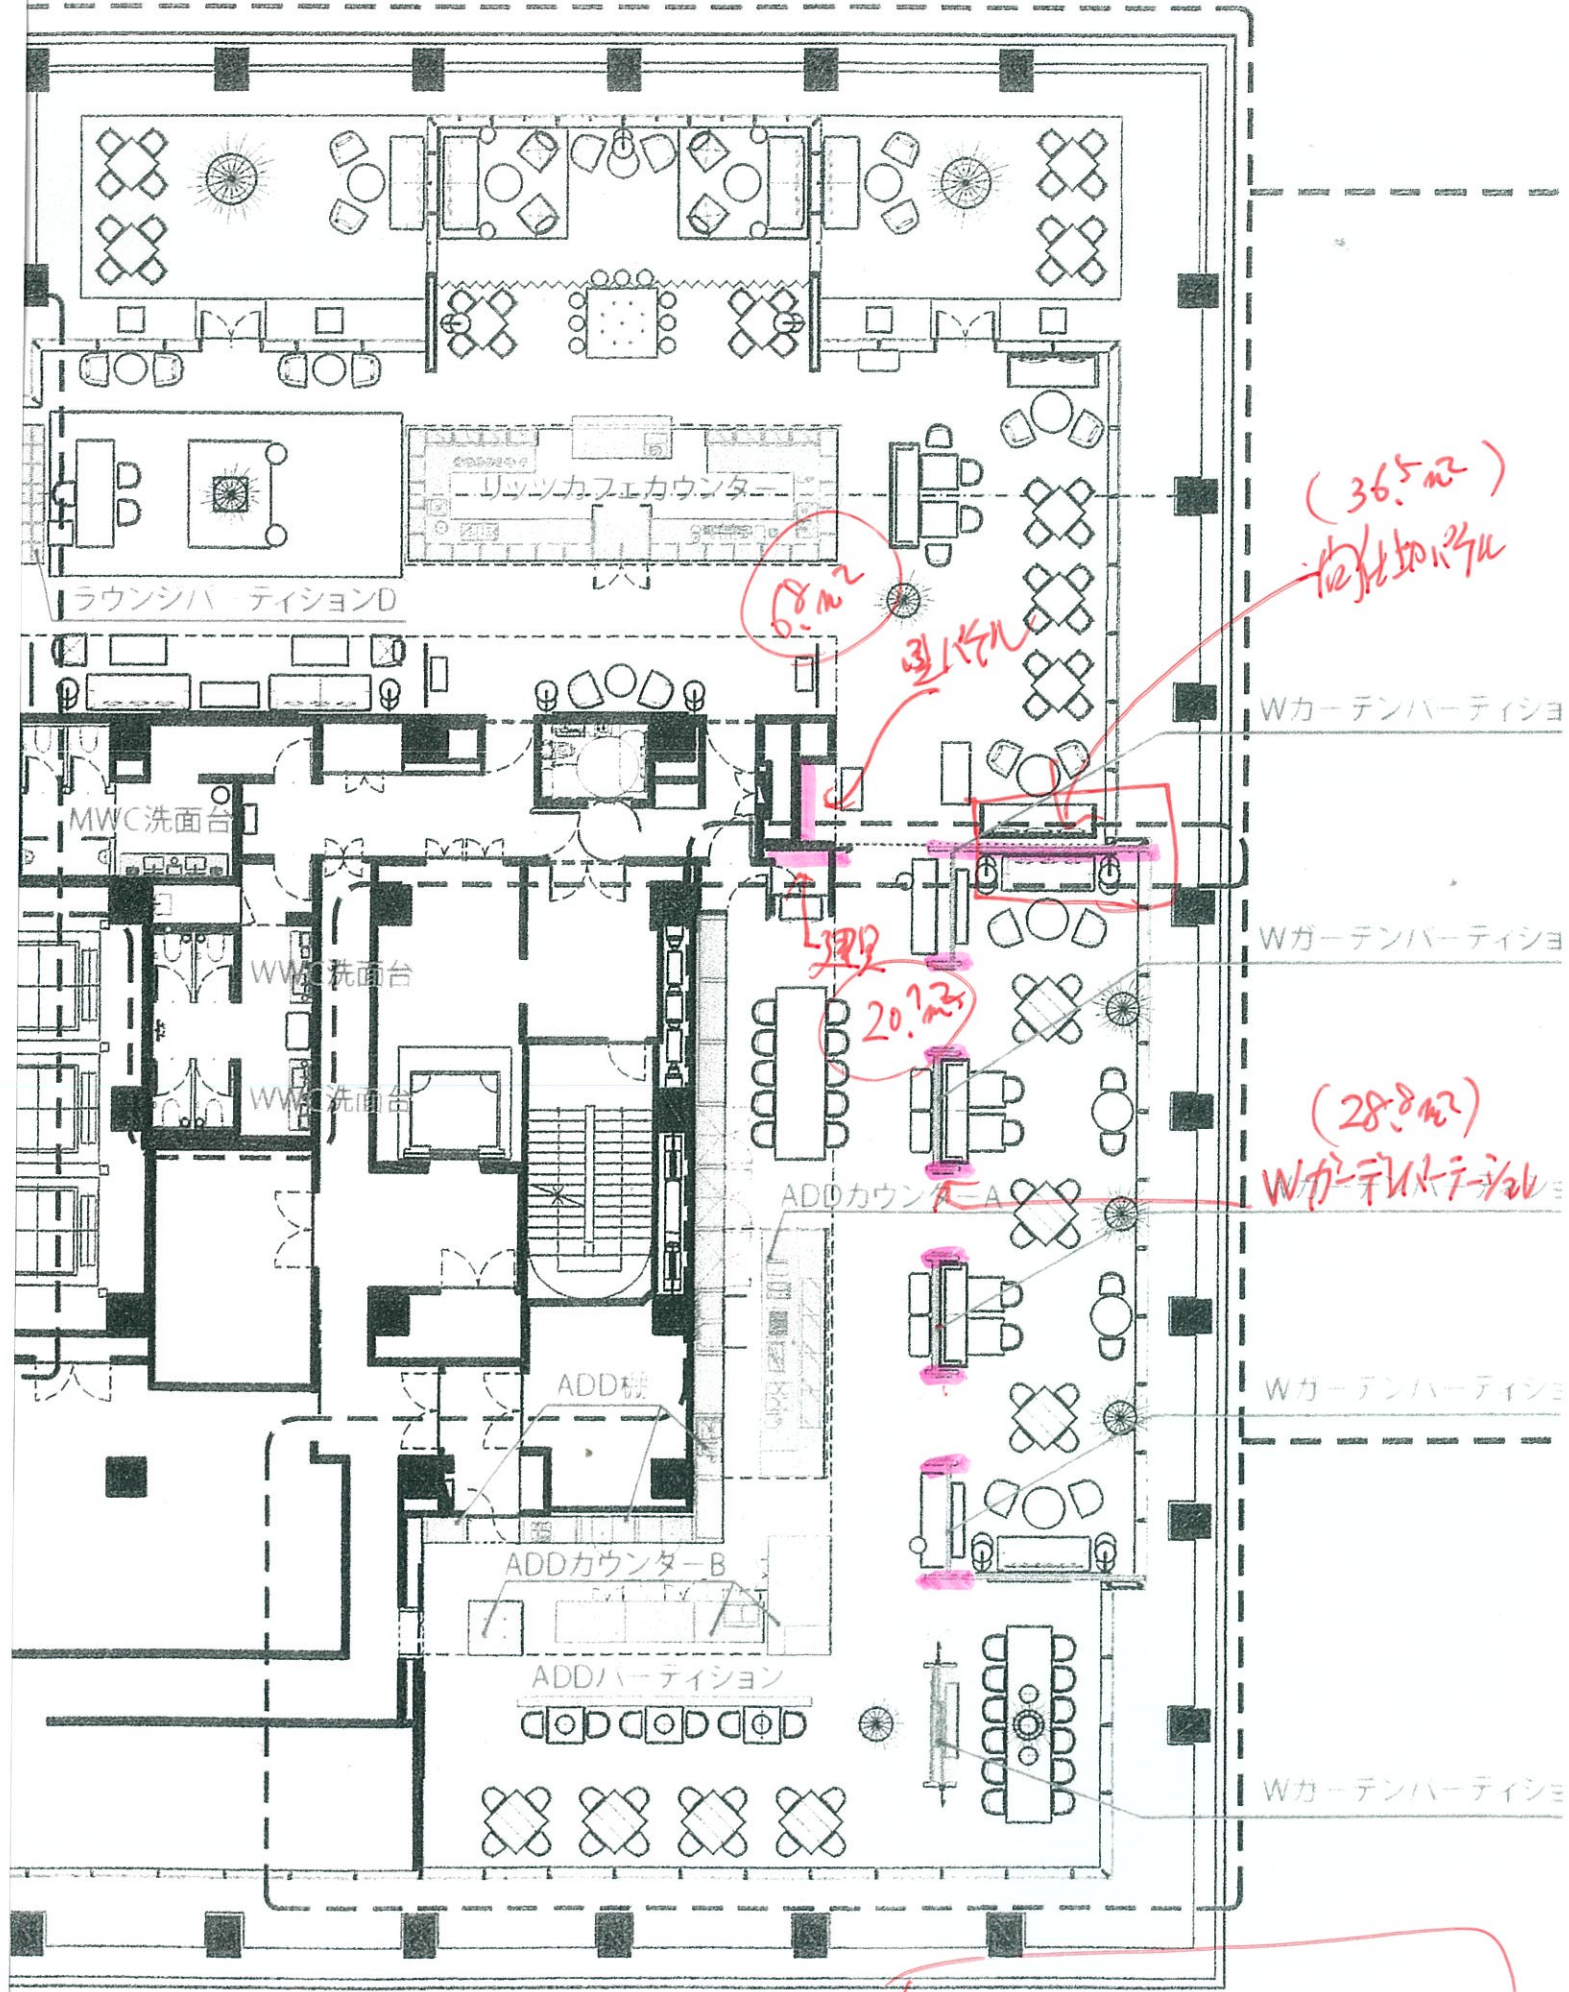


計 74.8 m²

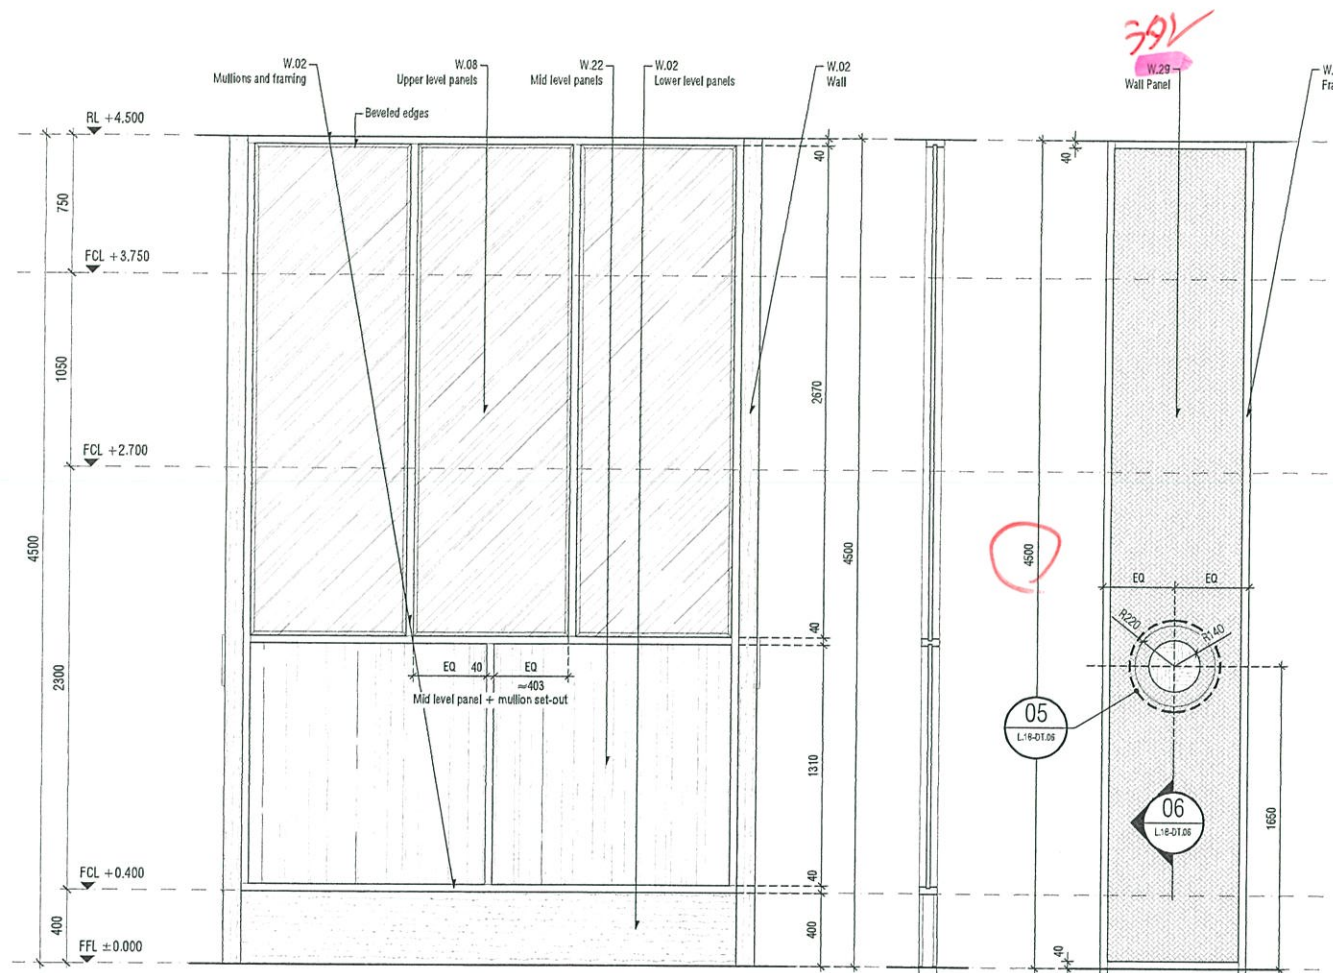


01 - Elevation
1:20 @ A1

03 - Section
1:20 @ A1


04 - Elevation
1:20 @ A1

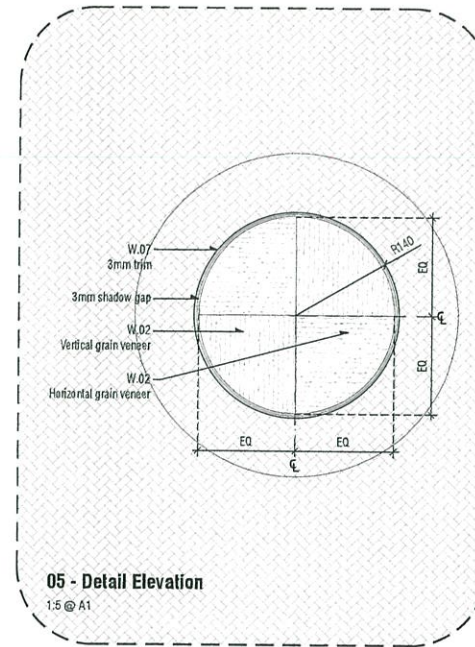

05 - Detail Elevation
1:5 @ A1

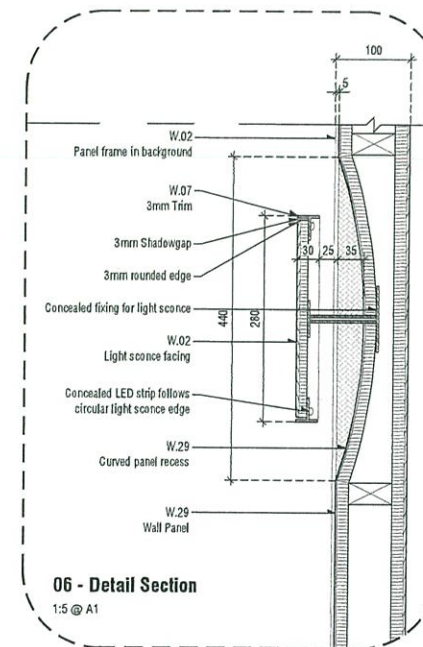

06 - Detail Section
1:5 @ A1

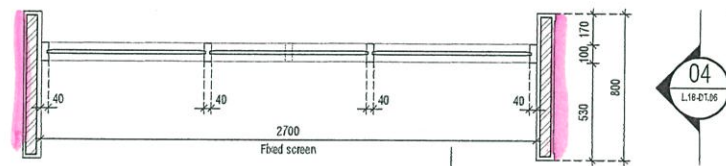

02 - Plan
1:20 @ A1

01
L:18-DT.06

03
L:18-DT.06

04
L:18-DT.06

Wカーディバ-テ-1/2 W x H 800 4500 8ヶ所

revision notes
- 09.07.2021 100% DD2

Do not scale drawing. Figured dimensions are to be followed. All measurements are to be verified on site. Any discrepancies are to be reported to the architect or designer. The contractor is to provide shopdrawings for approval.

The copyright of all design shown on this drawing set is the property of LAYAN Design Group and may not be reproduced or copied in any way without the written consent of an authorized company representative.

project
RITZ-CARLTON FUKUOKA
FUKUOKA - JAPAN



client
SEKISUI HOUSE, LTD.



design stage + content
DESIGN DOCUMENTATION 2


Details
Level 18 Lobby, Bar & All Day Dining

date drawn 09.07.2021	stage code DD2	project code 289
date last revised -	scale Varies @ A1	
drawing number 289-ID-L.18-DT.06	revision -	

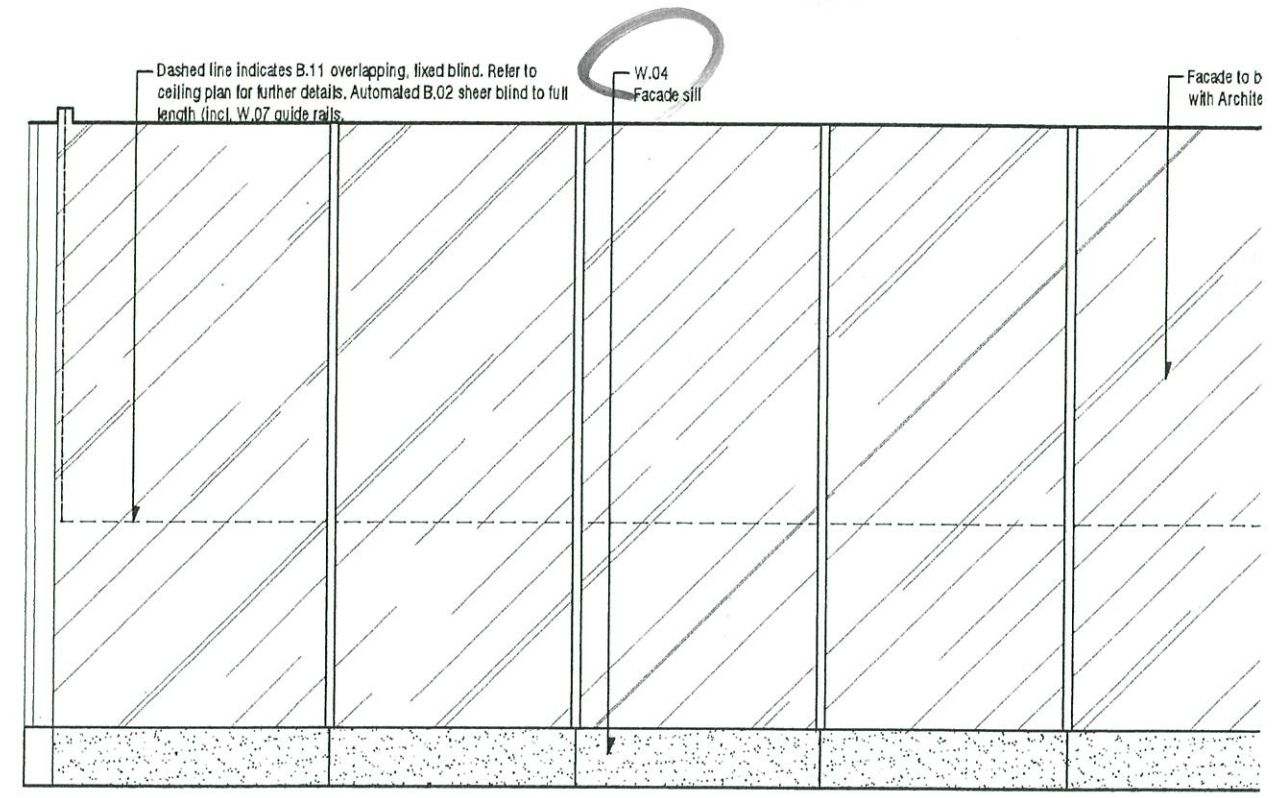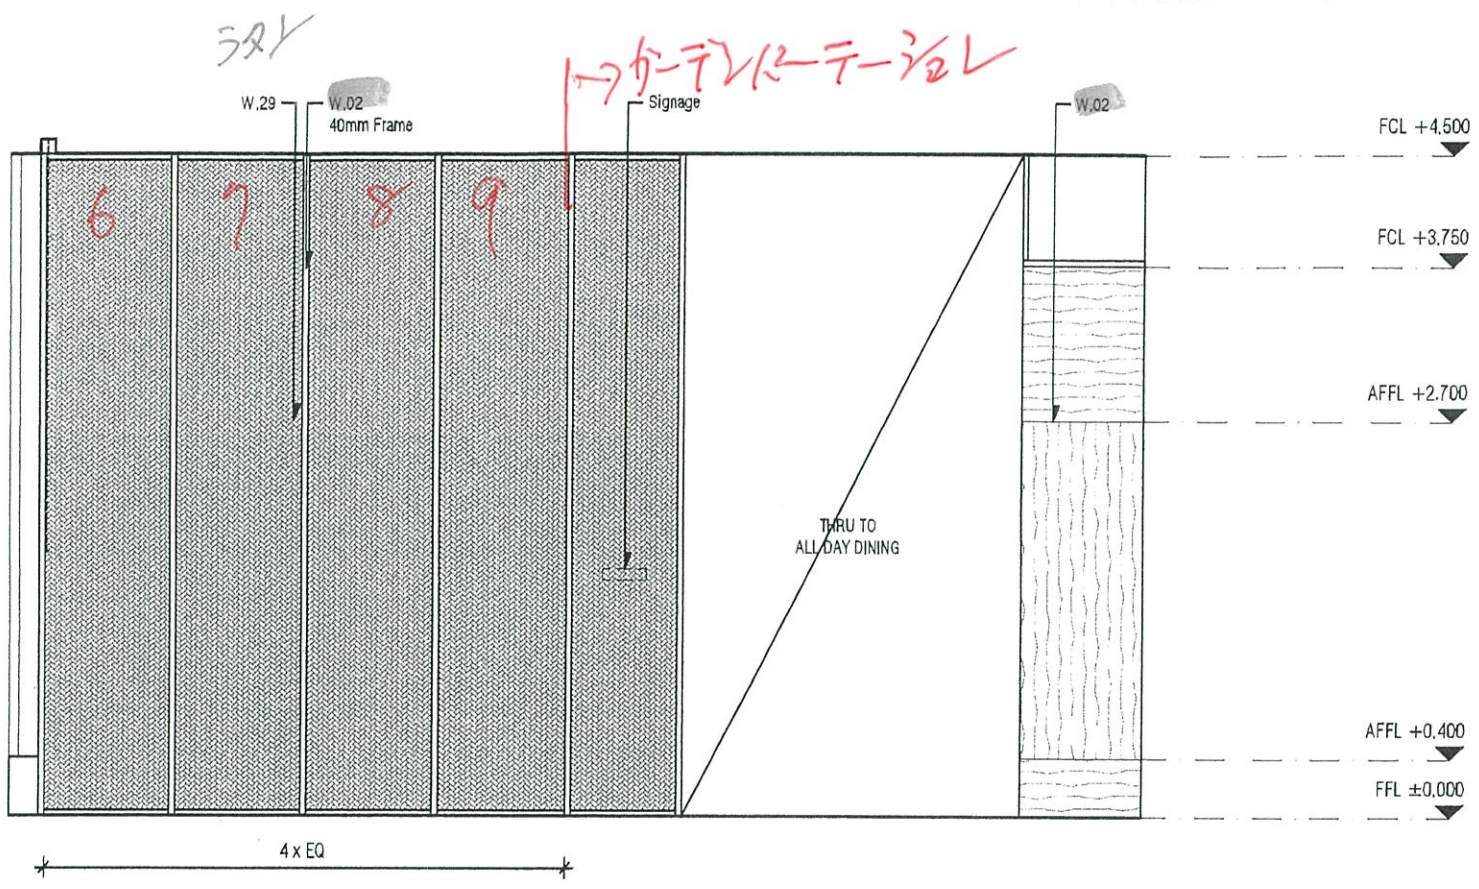


49 WALL ELEVATION - L.18
1:50 @ A1

50 WALL ELEVATION - L.18
1:50 @ A1

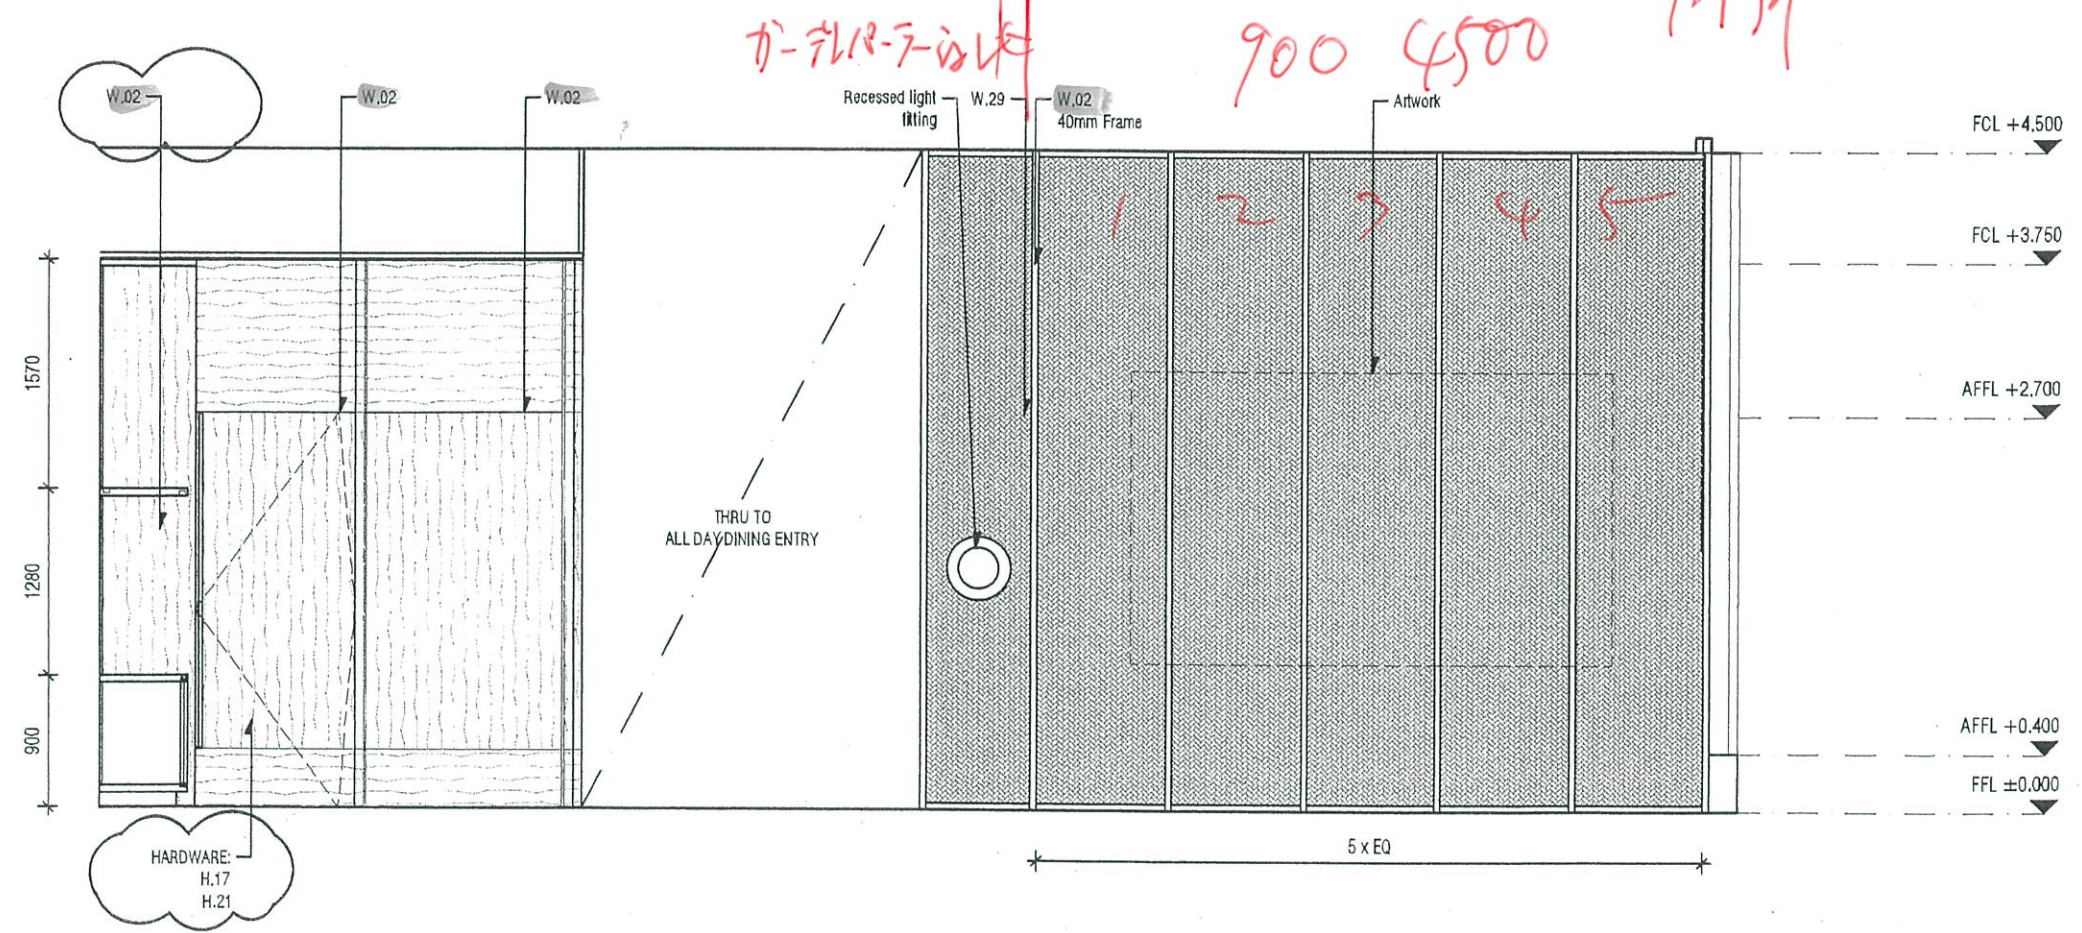

36.52
9434
900 4500

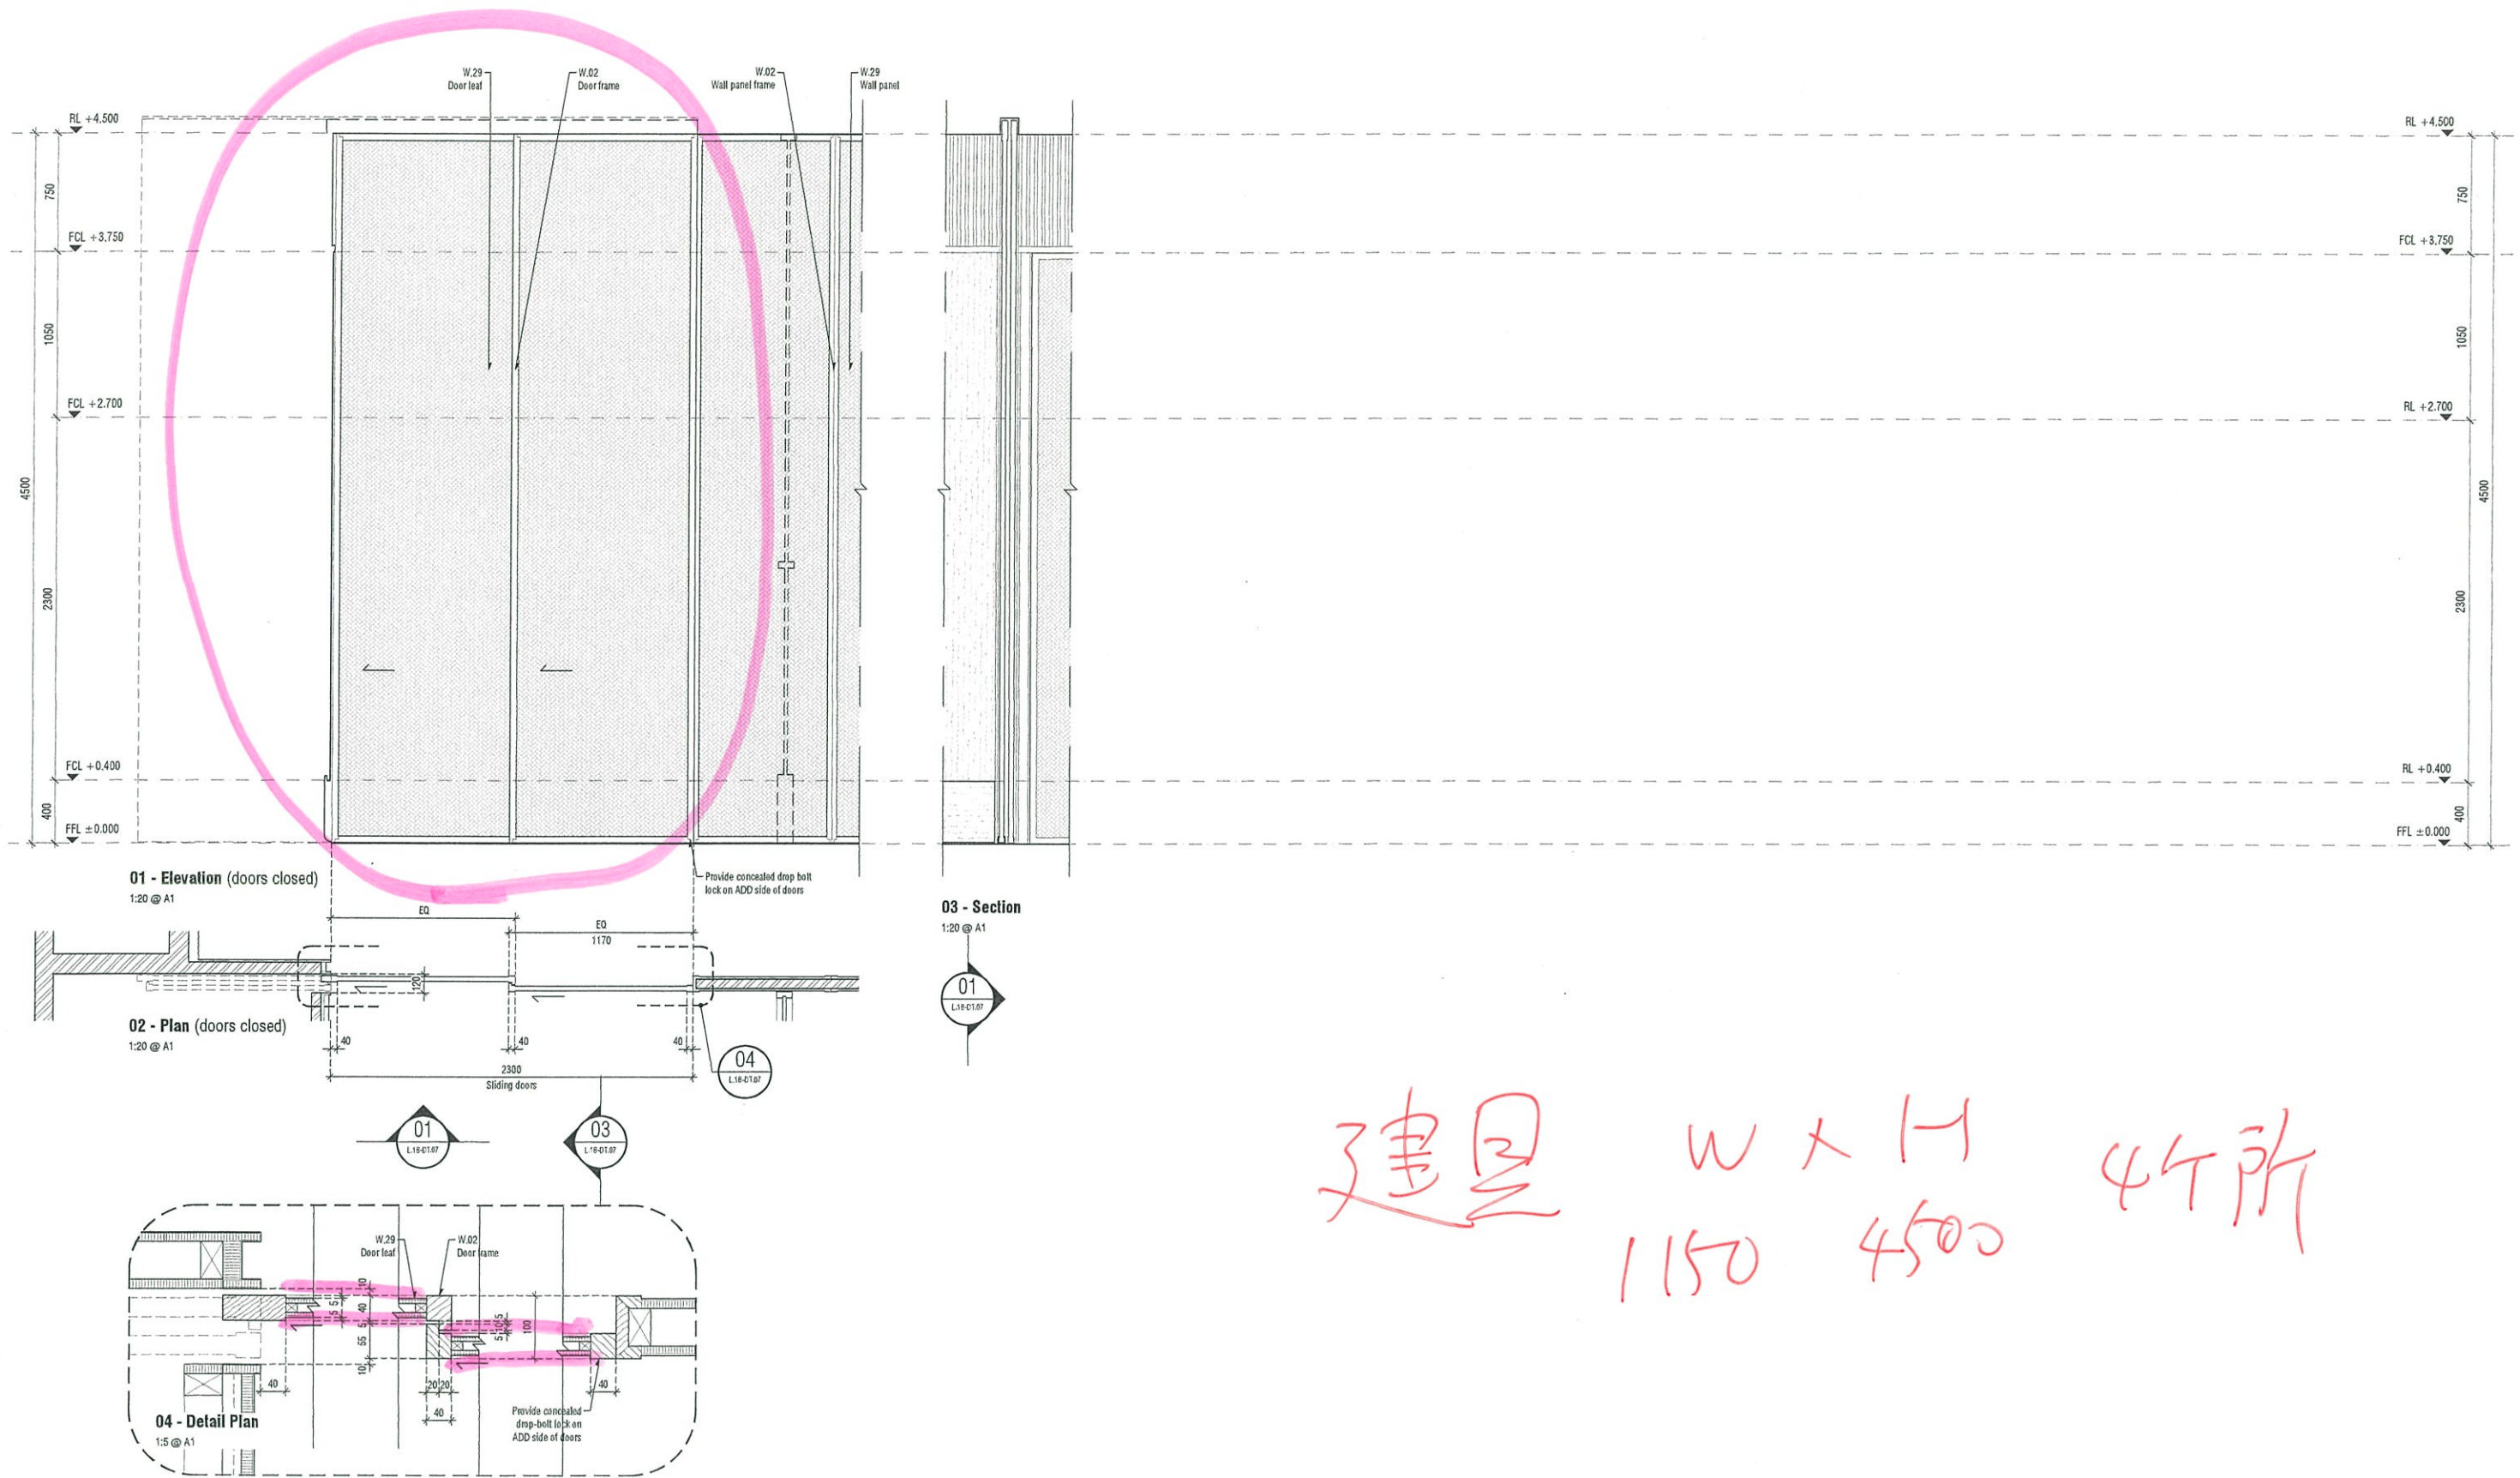

建具 W x H 44所
1150 4500

revision notes
- 09.07.2021 100% DD2

Do not scale drawing. Figured dimensions are to be followed. All measurements are to be verified on site. Any discrepancies are to be reported to the architect or designer. The contractor is to provide shopdrawings for approval.

The copyright of all design shown on this drawing set is the property of LAYAN Design Group and may not be reproduced or copied in any way without the written consent of an authorized company representative.

project
RITZ-CARLTON FUKUOKA
FUKUOKA - JAPAN

client
SEKISUI HOUSE, LTD.




design stage + content
DESIGN DOCUMENTATION 2


Details
Level 18 Lobby, Bar & All Day Dining

date drawn 09.07.2021	stage code DD2	project code 289
date last revised -	scale Varies @ A1	revision
drawing number 289-ID-L.18-DT.07	revision -	


38

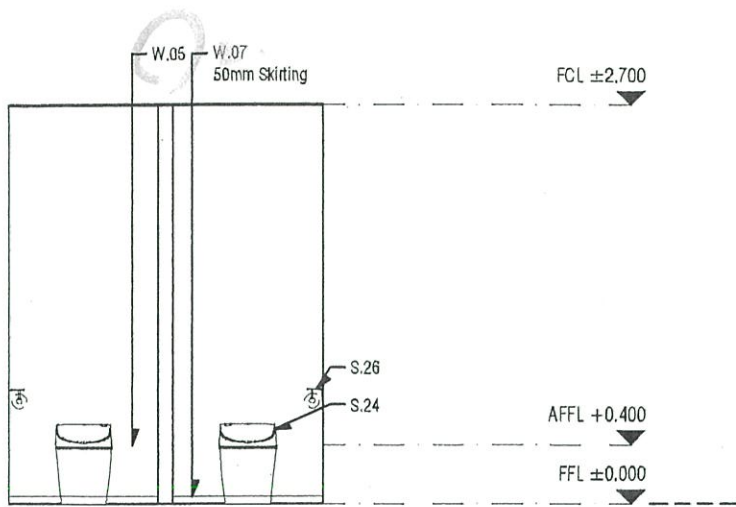

44 WALL ELEVATION - L.18
1:50 @ A1

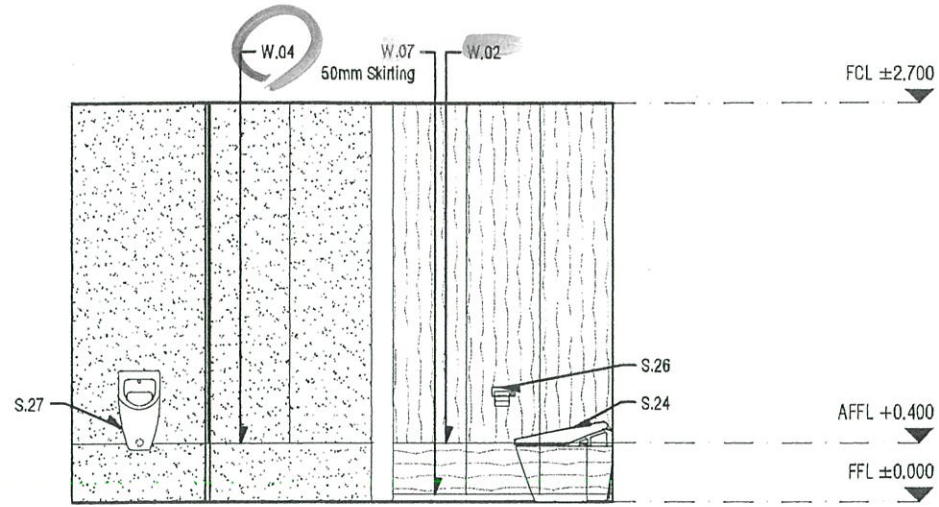


45 WALL ELEVATION - L.18
1:50 @ A1

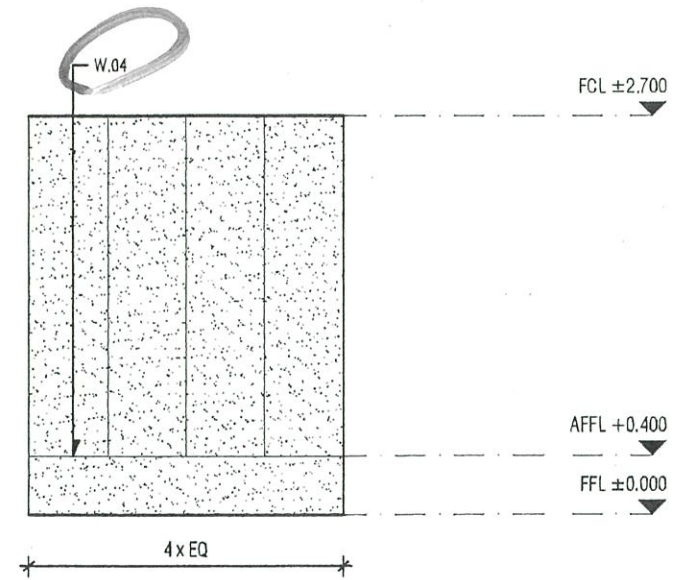

46 WALL ELEVATION - L.18
1:50 @ A1

Handwritten notes in red ink:
 W H
 33 10 900 3750 24 24

Handwritten initials: HNL

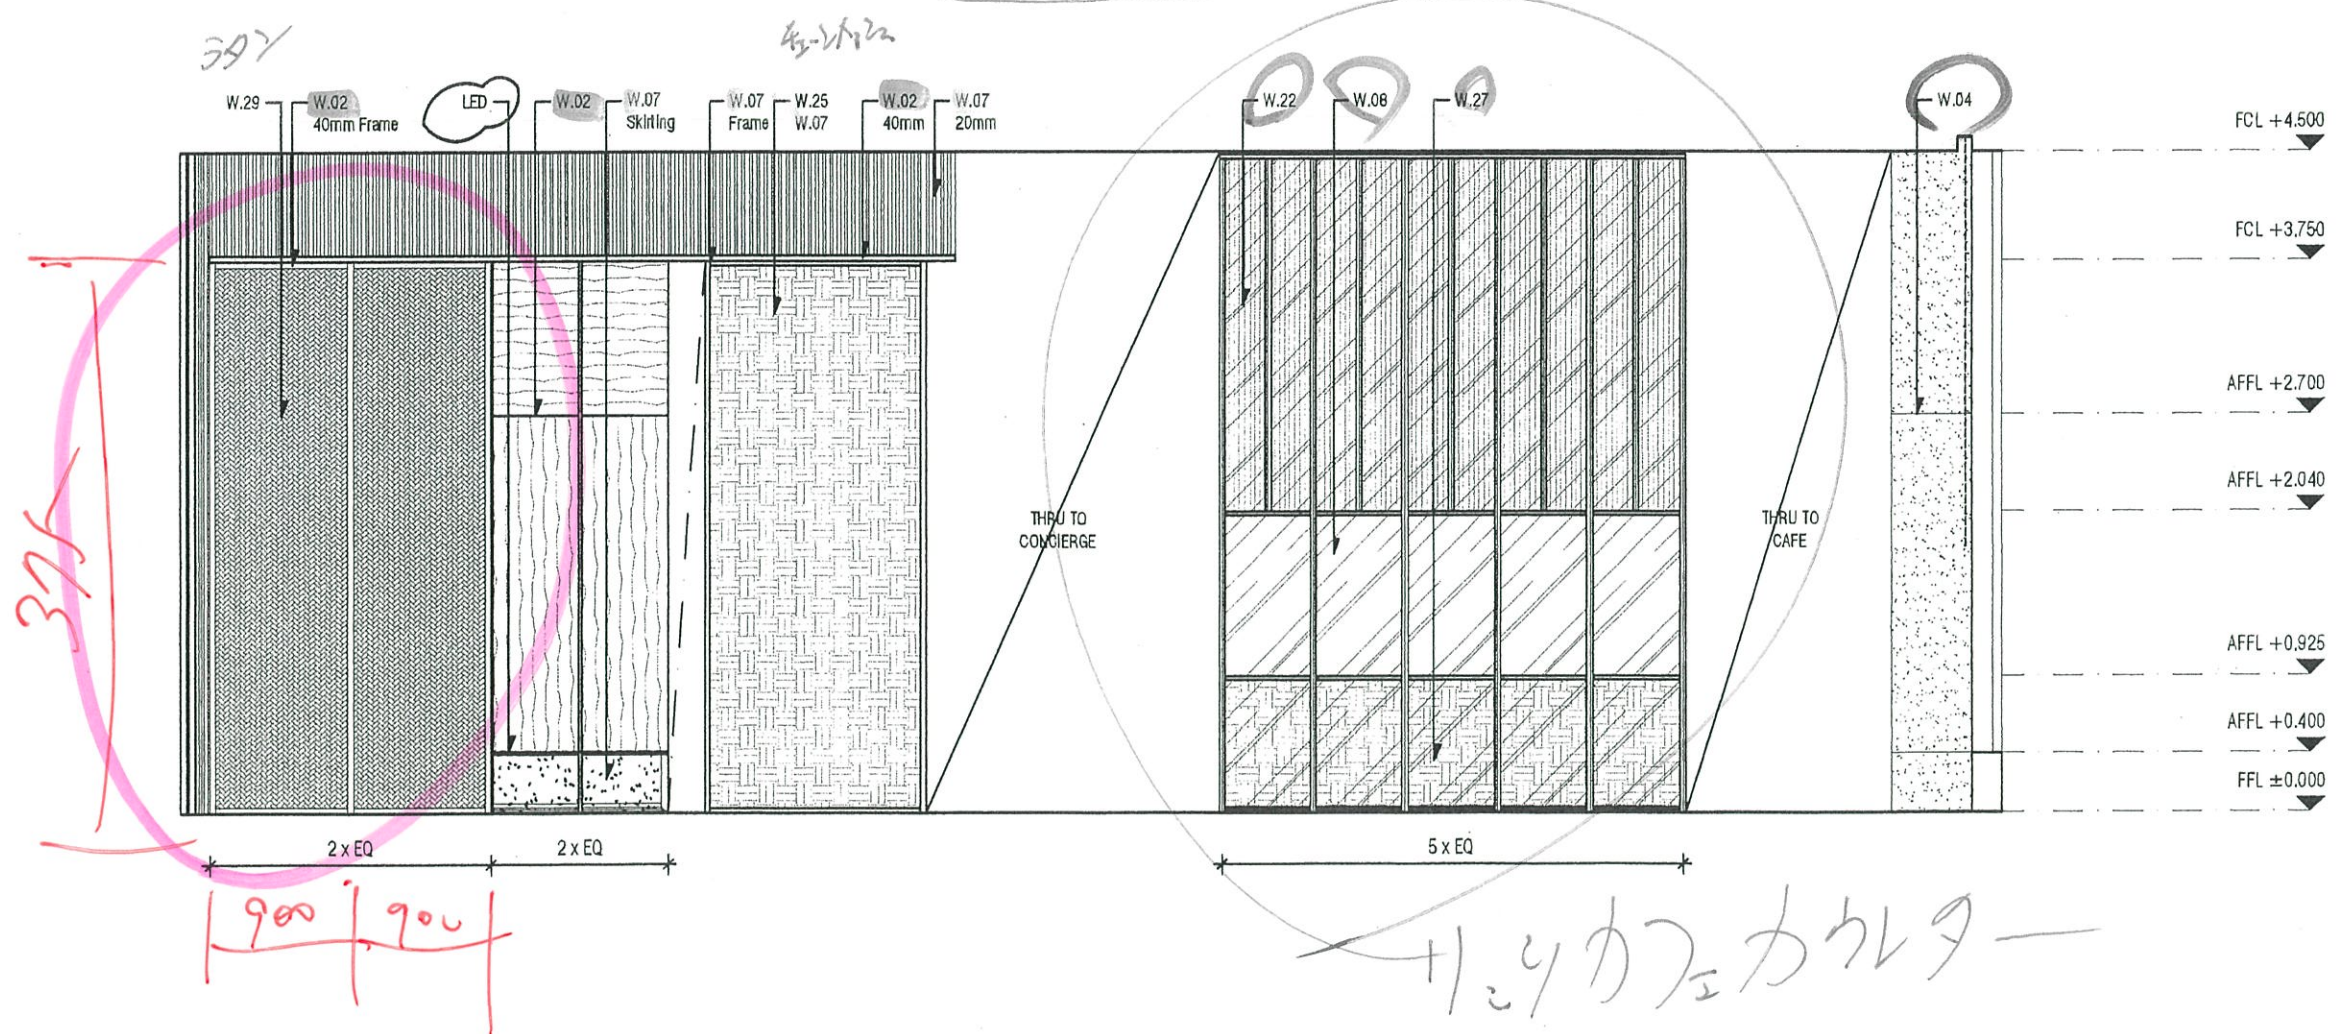

48 WALL ELEVATION - L.18
1:50 @ A1